

THE CORNER PROVISIONS




The Corner Provisions 03-17-2022

LAYOUT VIEW
20 SF

4"x4" SQUARE TUBE FRAME TO HAVE FLAT ALUMINUM FACE WITH REMOVABLE ALUMINUM TENANT PANELS AND DECORATIVE HDU POST CAPS. ALL COPY WILL BE CUT VINYL. TENANT PANEL MOUNTING WILL BE ACCESSIBLE BY REMOVABLE REAR PANEL.

Timber Cap to match building aesthetic. (By Others)

Brick/Stone to match building aesthetic. (By Others)

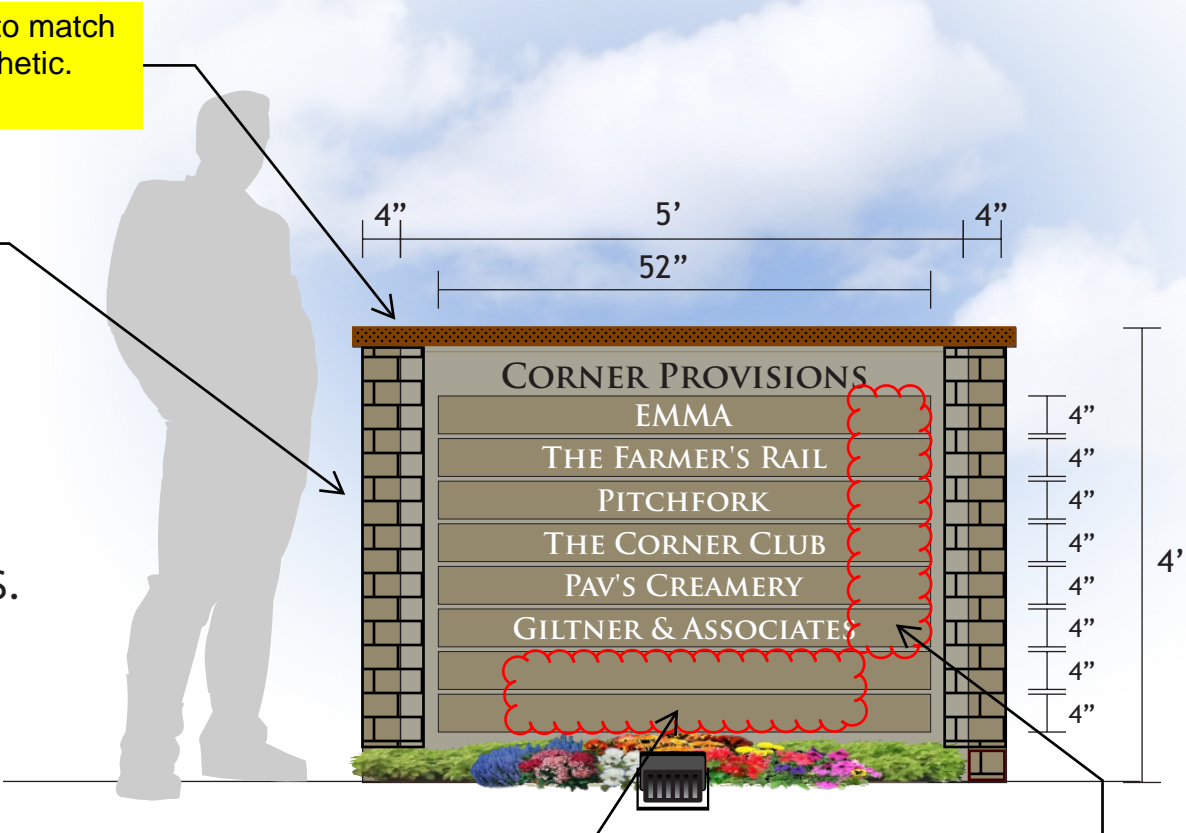

Please advise additional tenants


Please specify desired logos for final design revision

CLIENT REVIEW STATUS

<input type="checkbox"/>	APPROVED	<input type="checkbox"/>
<input type="checkbox"/>	REVISE & RESUBMIT	
NAME: _____		DATE: _____

THIS IS NOT A SHOP DRAWING

NON INTERNALLY ILLUMINATED (EXTERNALLY ILLUMINATED)
MULTI-TENANT SIGN
ALUMINUM CONSTRUCTION

 1917 HENRY AVE. SW. CANTON, OH 44706 P: 330-455-9995 F: 330-455-9994 www.archersign.com	CUSTOMER: The Corner Provisions	LOCATION: LOCATION	SALESPERSON: JERRY ARCHER	DRAWN BY: STEVE L.	REVISIONS:	<small>THIS ORIGINAL DESIGN IS THE EXCLUSIVE PROPERTY OF THE ARCHER SIGN CORPORATION, AND IS PROTECTED BY FEDERAL COPYRIGHT LAWS. ANY REPRODUCTION, OR CONSTRUCTION OF ANY SIGN SIMILAR TO THE ONE EMBODIED HEREIN, IS EXPRESSLY FORBIDDEN AND WILL RESULT IN A PENALTY FEE OF UP TO TEN PERCENT OF THE TOTAL JOB COST, PAYABLE TO THE ARCHER SIGN CORPORATION.</small>
	DATE: 03-17-2022	PROJECT MANAGER: ASHLEY NEWBOLD	FILE LOCATION: STEVE LANGFORD FILES	MISC INFORMATION:	NOTE: ALL ILLUMINATED SIGNS MANUFACTURED FOR 120 VOLT CIRCUIT (UNLESS SPECIFIED).	