


Elevations Table

Number	Minimum Elevation	Maximum Elevation	Depth	Color
1	847.19	852.00	6' - 10'	Blue
2	852.00	854.00	4' - 6'	Green
3	854.00	856.00	2' - 4'	Yellow
4	856.00	858.00	0' - 2'	Orange

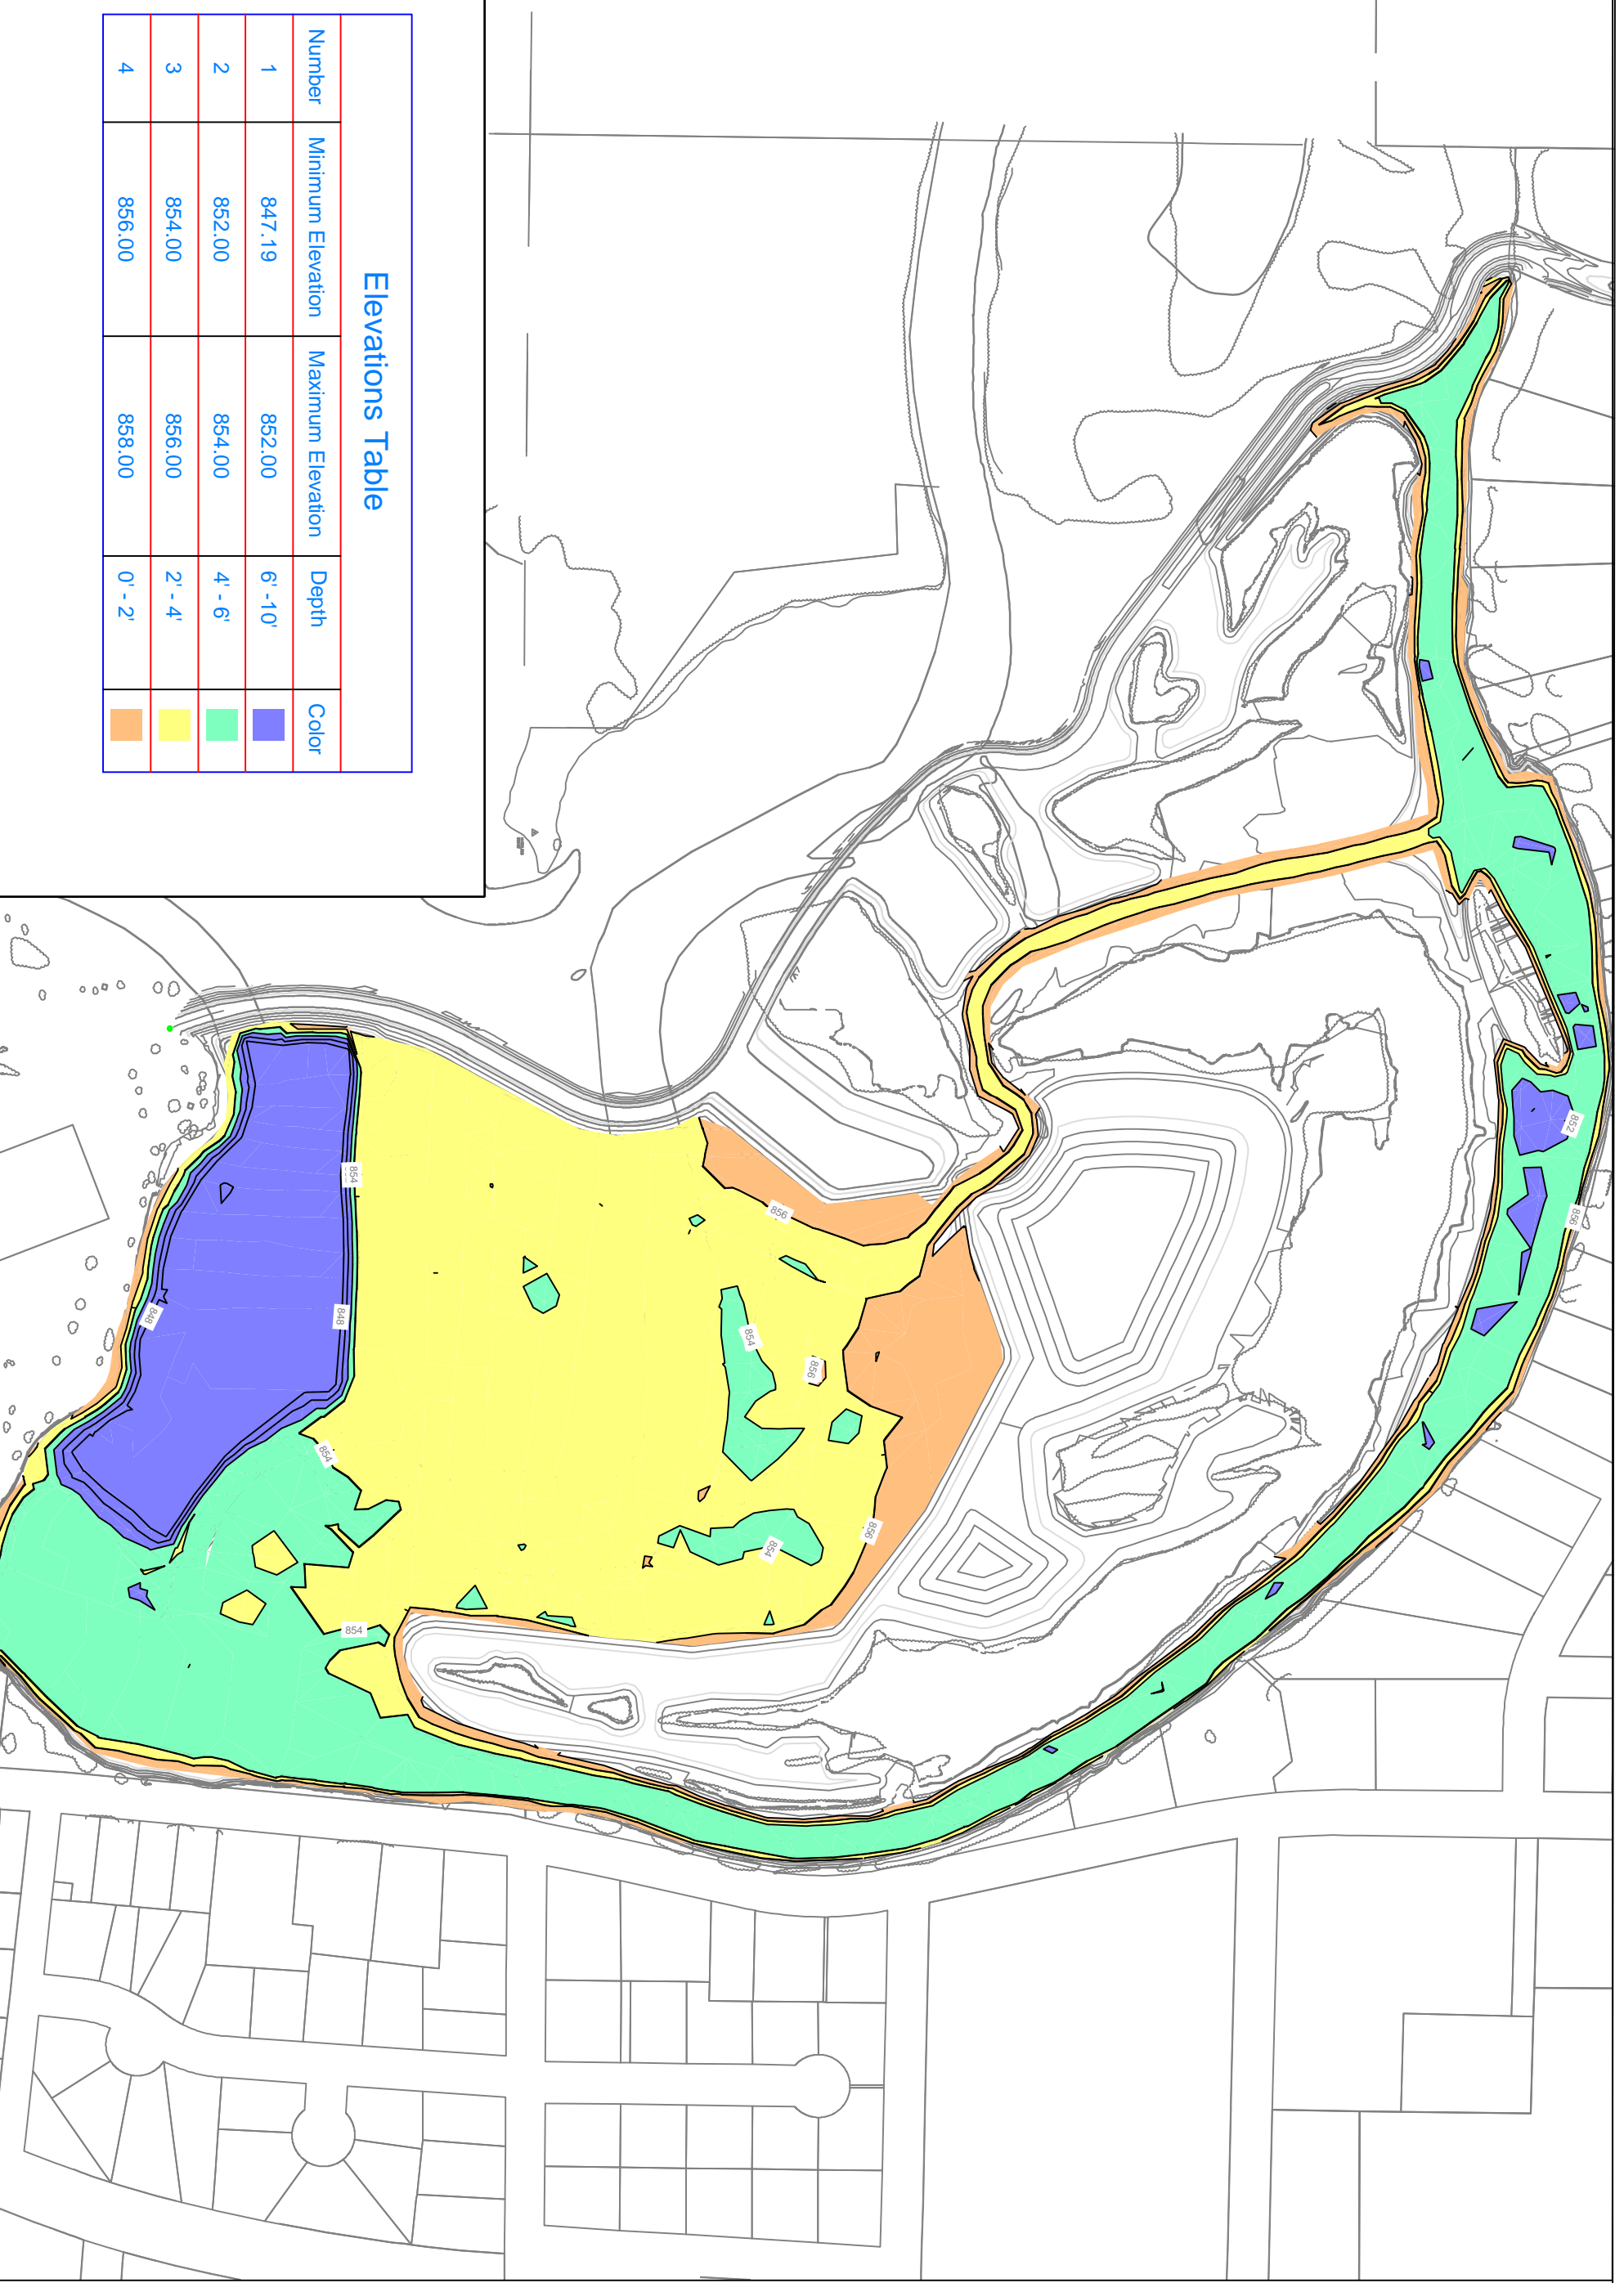

SCALE
1" = 250'

IF THIS BAR DOES NOT MEASURE 1" THEN THE DRAWING IS NOT TO SCALE

PROJECT NO. 1428-02 DATE 06/01/11
SHEET NO. 1/1

AS BUILT DEPTHS

LAKE BELLE VIEW LAKE RESTORATION
BELLEVILLE, WI

VILLAGE OF BELLEVILLE

MONTGOMERY ASSOCIATES:
RESOURCE SOLUTIONS, LLC
119 SOUTH MAIN STREET
SUITE A
COTTAGE GROVE, WI 53527
www.ma-rs.org

NO.	REVISION / ISSUE	DATE

DRAWN BY **SGS** CHECKED BY **JMH**