


## BASEMENT & FOUNDATION PLAN

SCALE: 1/4" = 1'-0"

**WALL LEGEND**

- NEW CONSTRUCTION
- EXISTING CONSTRUCTION
- CONSTRUCTION TO BE REMOVED

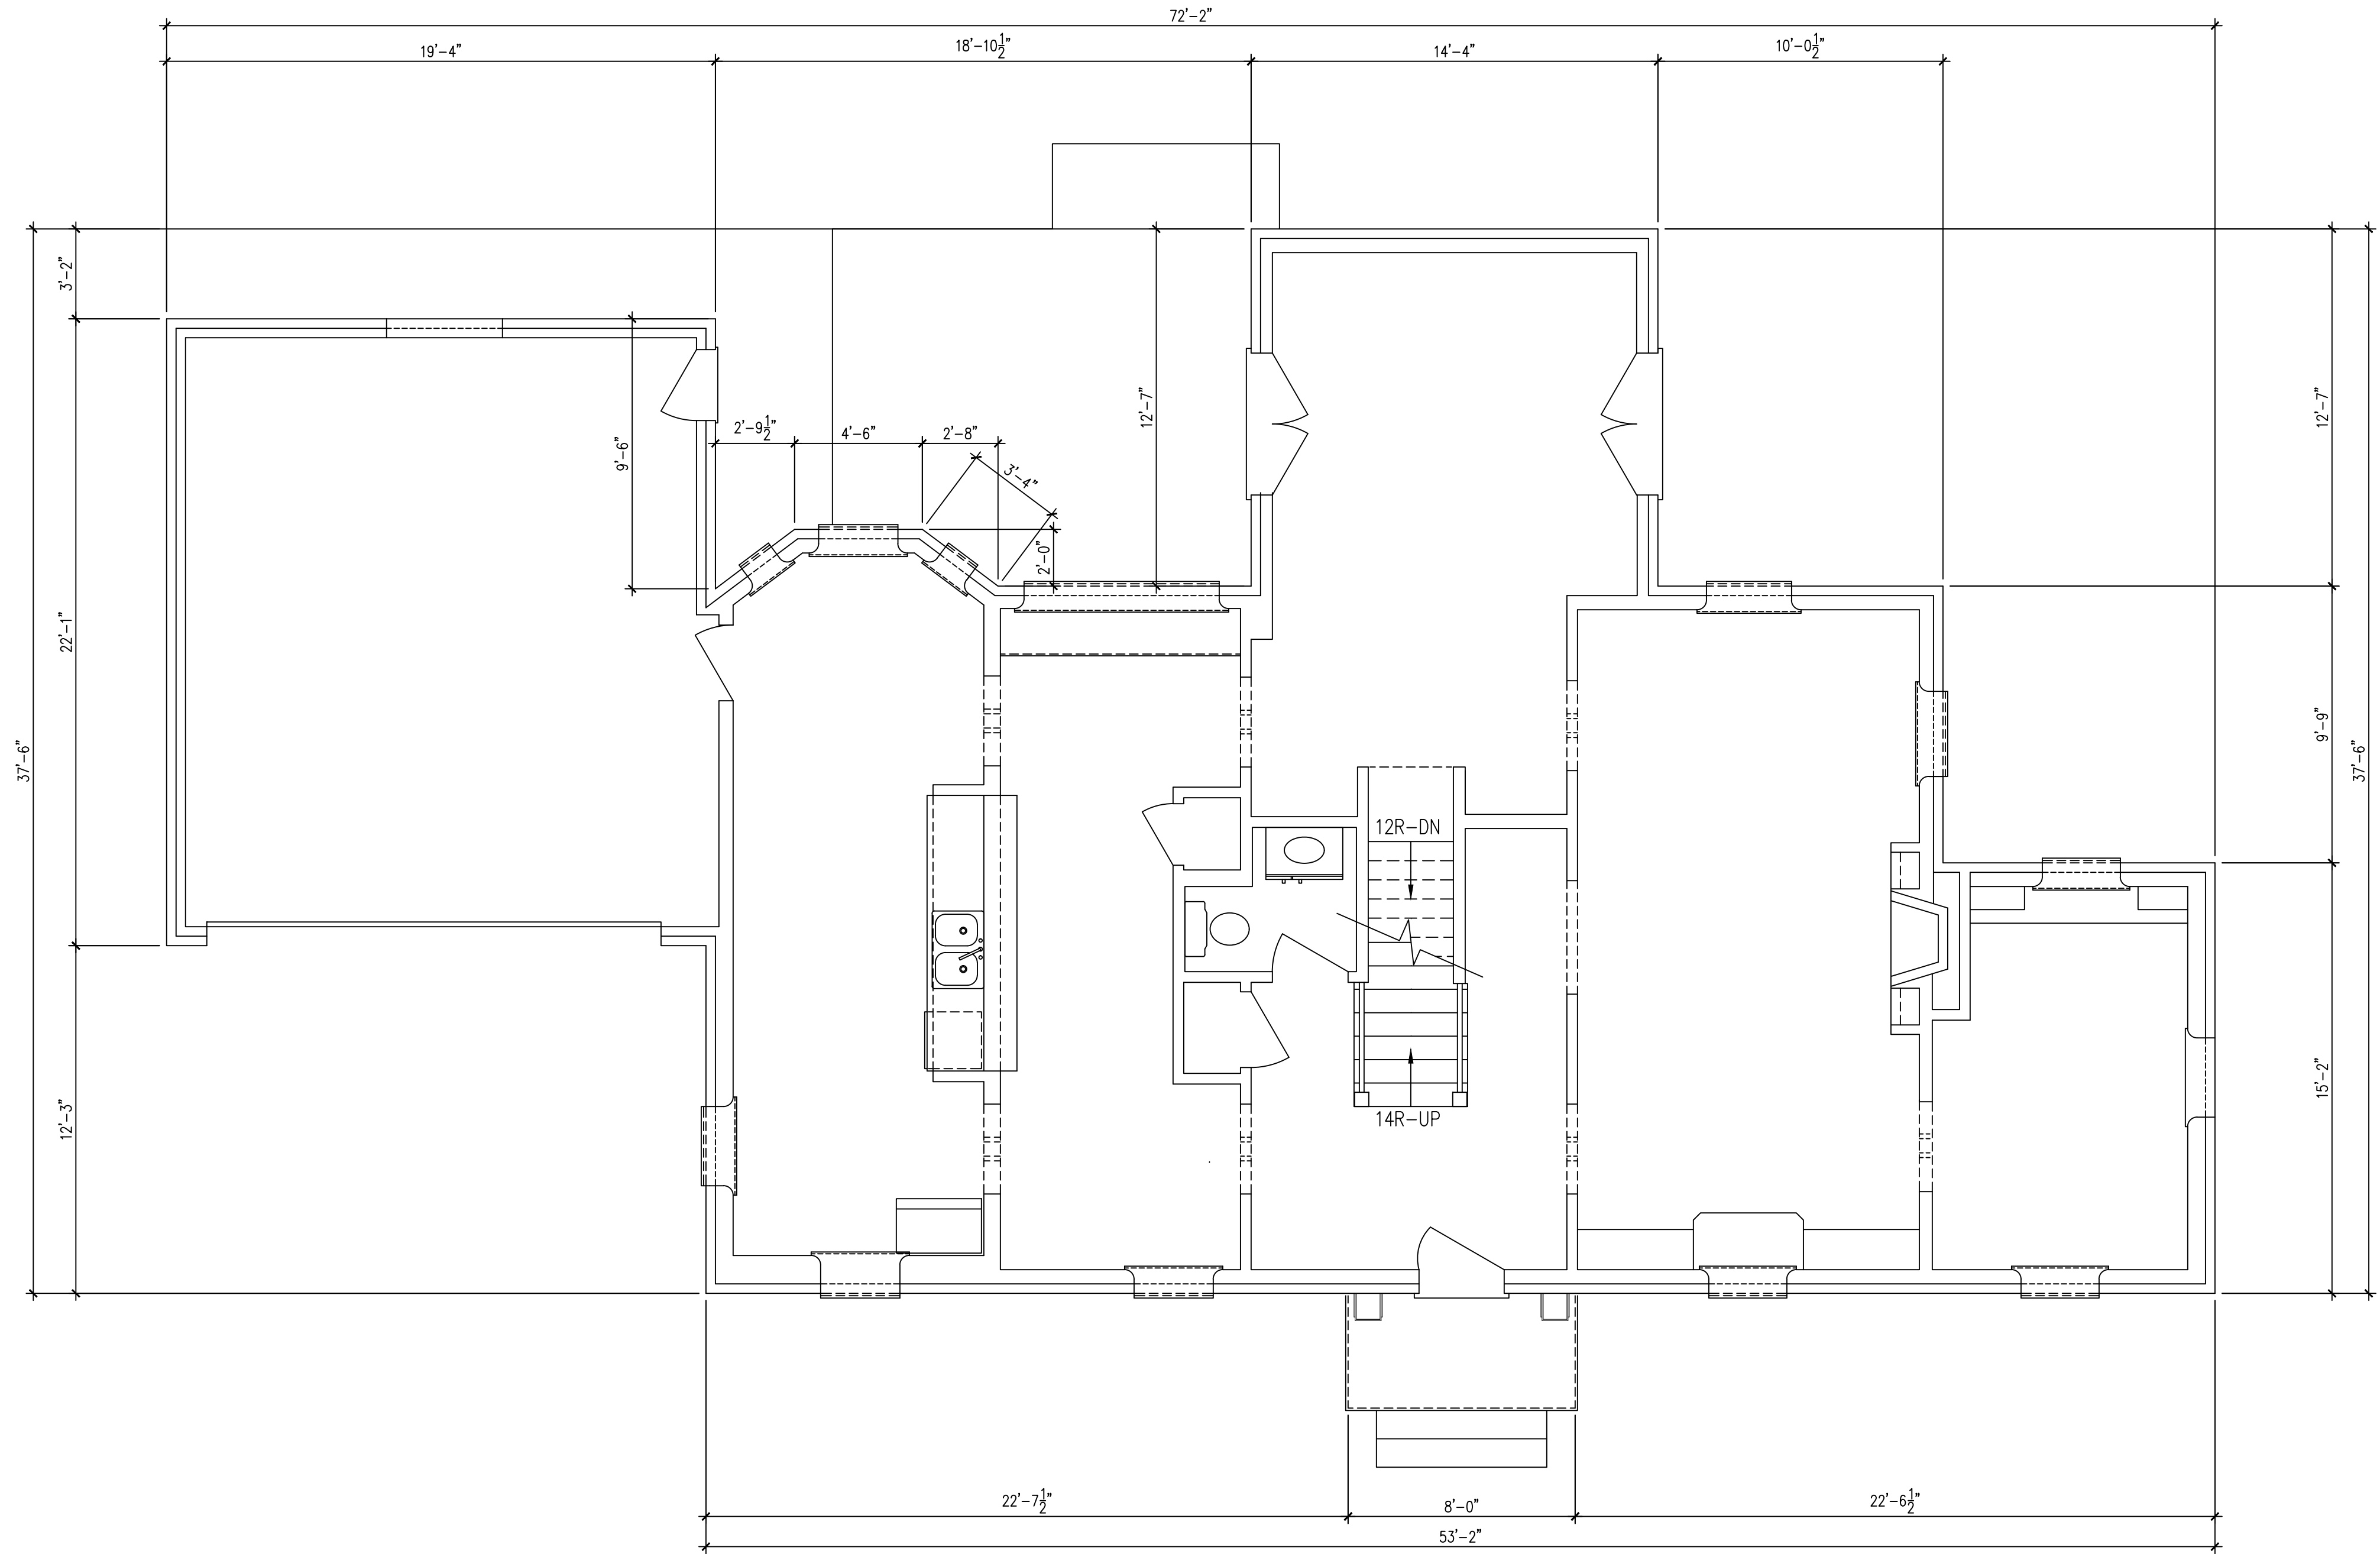

**MAIN LEVEL PLAN**

SCALE: 1/4" = 1'-0"

**CHRIS MORGAN & ASSOCIATES, INC.**  
 DESIGN-BUILD  
 4435 NEWCASTLE DR., CLARKSTON MI 48348 248-393-3462


**GREENBERG/VARNER RESIDENCE**  
 25812 SALEM, HUNTINGTON WOODS, MI 48070

**AS BUILT**  
 COPYRIGHT 2021

DRAWN BY:  
 C. MORGAN  
 C. RIEGLER

REVISIONS:

PAGE NO. #  
**A-2**

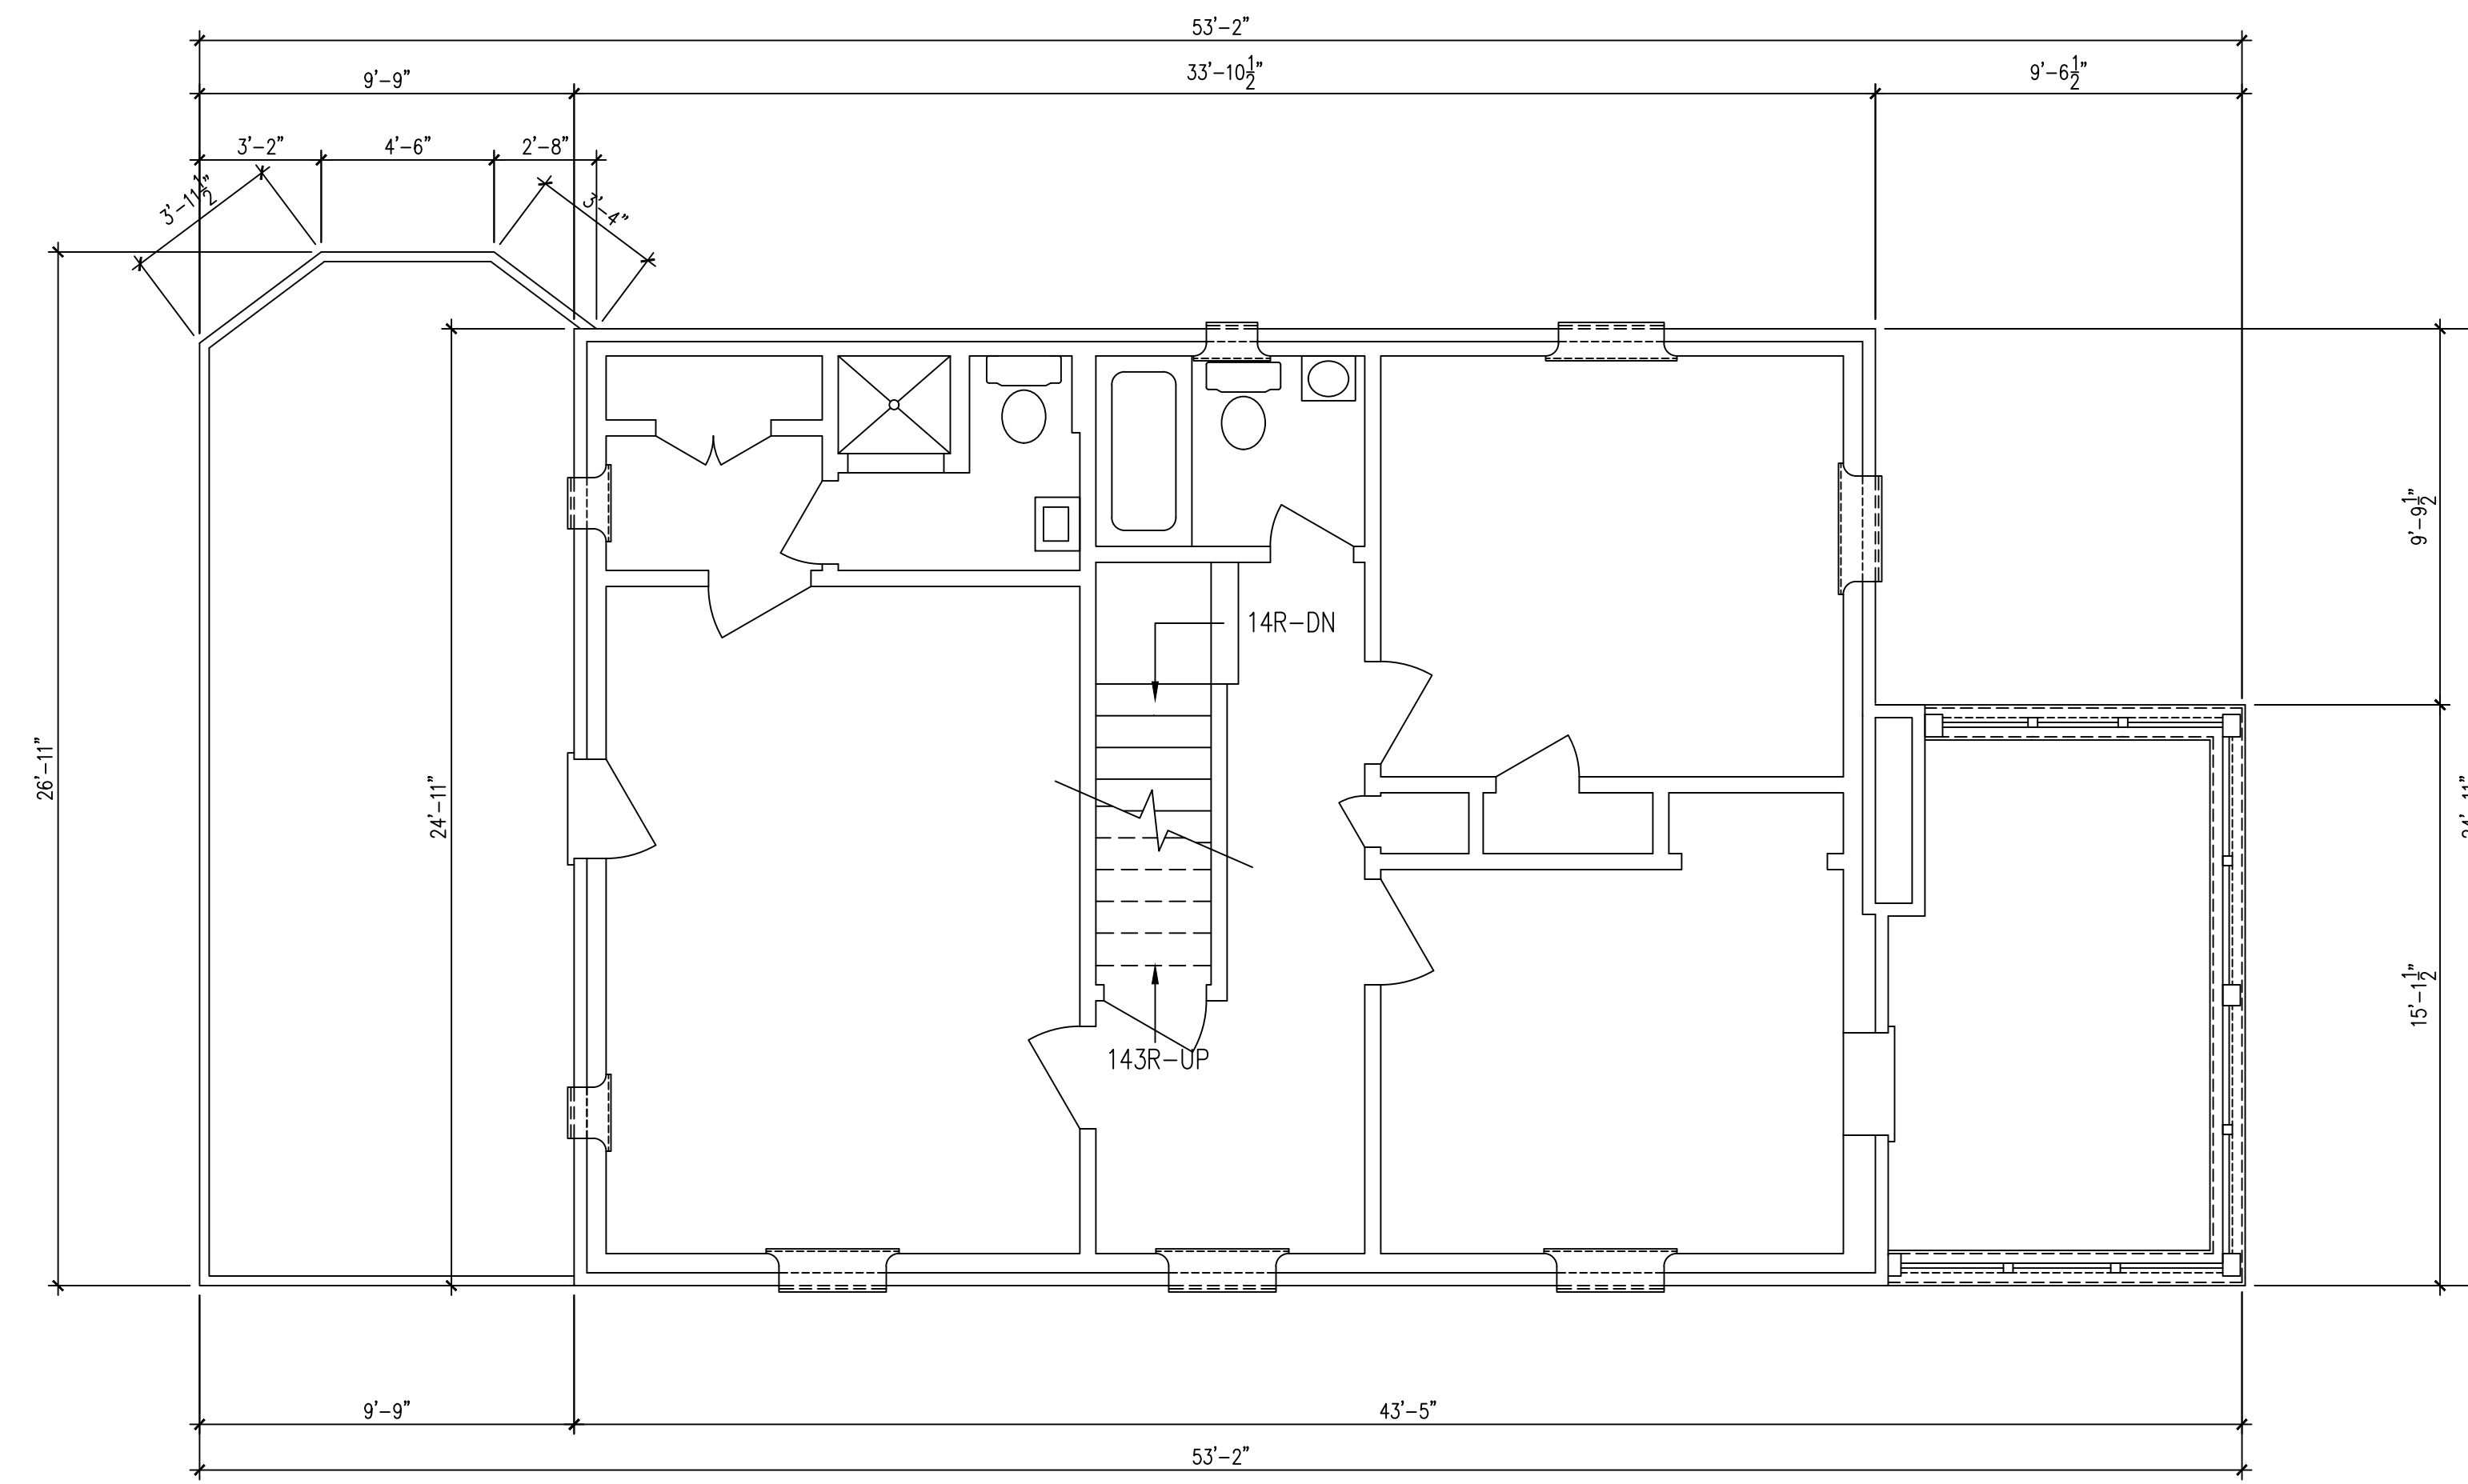

## SECOND LEVEL PLAN

SCALE: 1/4" = 1'-0"



WALL LEGEND

NEW CONSTRUCTION
EXISTING CONSTRUCTION
CONSTRUCTION TO BE REMOVED

LEFT ELEVATION

SCALE: 1/4" = 1'-0"



FRONT ELEVATION

SCALE: 1/4" = 1'-0"

CHRIS MORGAN & ASSOCIATES, INC.  
 DESIGN-BUILD  
 4435 NEWCASTLE DR., CLARKSTON MI 48348 248-393-3462

GREENBERG/VARNER RESIDENCE  
 25812 SALEM, HUNTINGTON WOODS, MI 48070

AS BUILT  
 COPYRIGHT 2021

DRAWN BY:  
 C. MORGAN  
 C. RIEGLER

REVISIONS:

PAGE NO. #

A-4

WALL LEGEND	
	NEW CONSTRUCTION
	EXISTING CONSTRUCTION
	CONSTRUCTION TO BE REMOVED



**RIGHT ELEVATION**

SCALE: 1/4" = 1'-0"



**REAR ELEVATION**

SCALE: 1/4" = 1'-0"

**CHRIS MORGAN & ASSOCIATES, INC.**  
 DESIGN-BUILD  
 4435 NEWCASTLE DR., CLARKSTON MI 48348 248-393-3462

**GREENBERG/VARNER RESIDENCE**  
 25812 SALEM, HUNTINGTON WOODS, MI 48070

**AS BUILT**  
 COPYRIGHT 2021

DRAWN BY:  
 C. MORGAN  
 C. RIEGLER

REVISIONS:

PAGE NO. #

**A-5**